

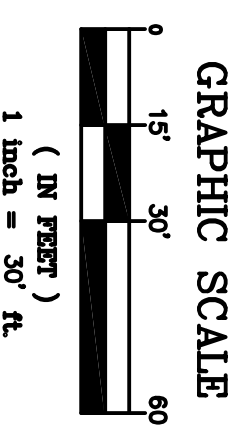


# AS-BUILT SURVEY

OF THE PROPOSED BED, BATH & BEYOND BUILDING PAD LOCATED ON MONROE STREET, IN THE CITY OF TOLEDO, LUCAS COUNTY, OHIO. PREPARED FOR BED, BATH & BEYOND AT THE REQUEST OF MR. TOM PHILLIPS

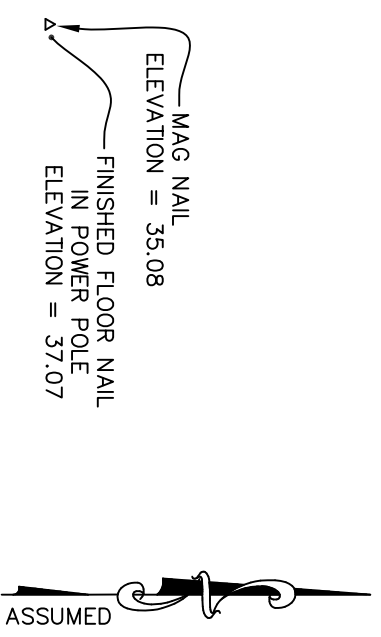

**Saneholtz & Associates, LLC**  
 P.O. Box 2628  
 Whitehouse, OH 43571  
 Phone: (419) 877-0400  
 Fax: (419) 877-1140  
 Mobile: (419) 350-8818  
 E-Mail: [ss@saneholtz.com](mailto:ss@saneholtz.com)

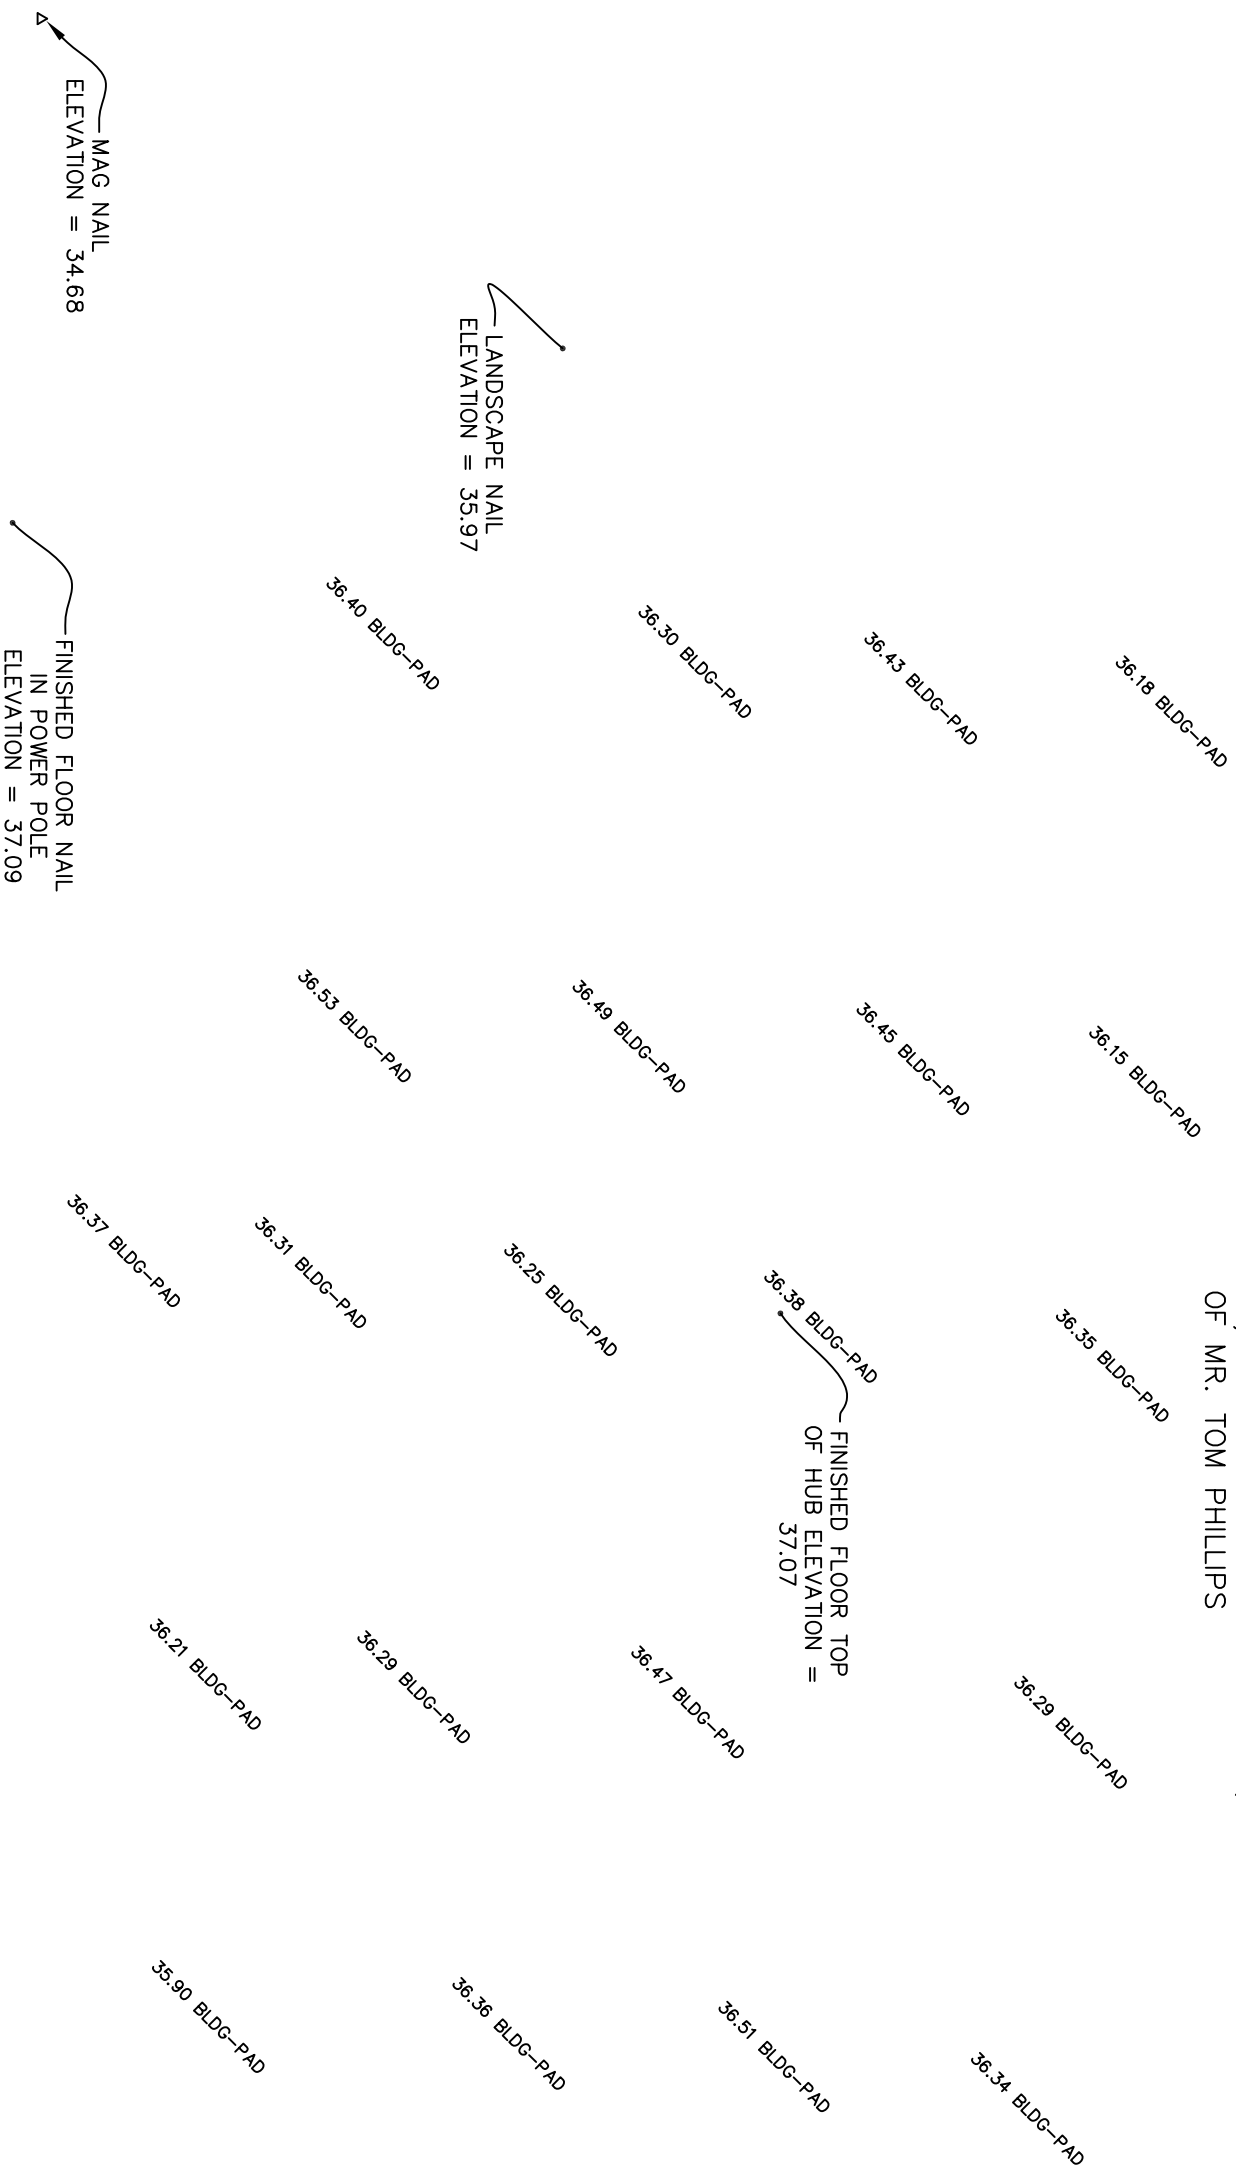

DATE: 07/20/05  
 PROJECT# 051S00854