AS-BUILT SURVEY

OF PART OF THE BUILDING PAD OF START HIGH SCHOOL
IN THE CITY OF TOLEDO, LUCAS COUNTY, OHIO.
PREPARED FOR AND AT THE REQUEST OF
ANDERZAK-PITZEN CONSTRUCTION

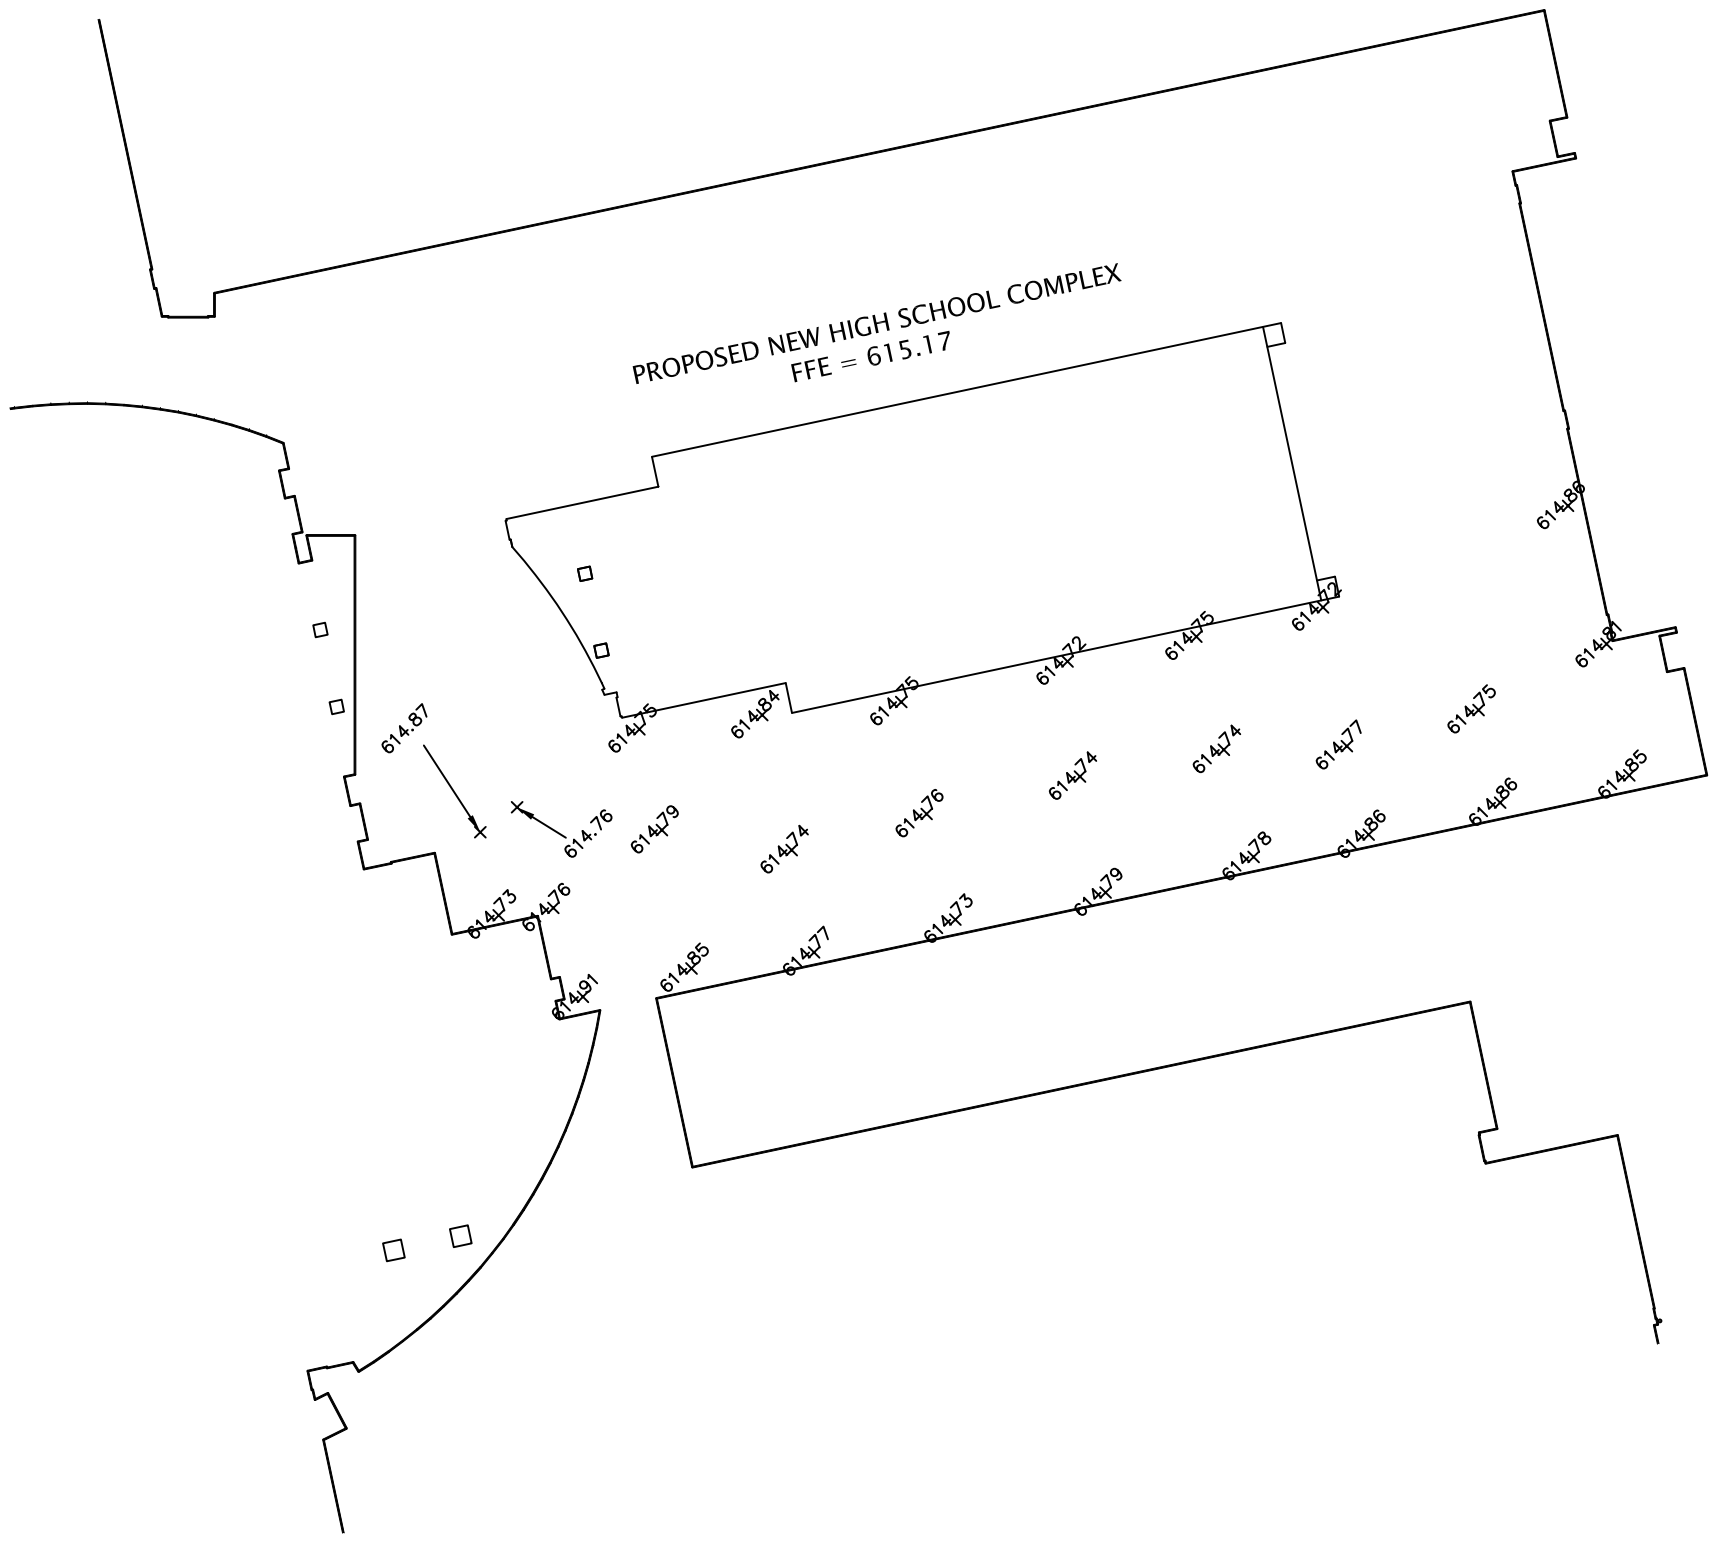

GRAPHIC SCALE

30 0 15 30 60 120

(IN FEET)
1 inch = 30 ft.

NOTES

OBSERVATIONS WERE TAKEN ON
FRIDAY NOVEMBER 11, 2005.

Anthony A. Garcia
Professional Surveyor No. 8112

Date

STATE OF OHIO
ANTHONY A. GARCIA
8112
REGISTERED
SURVEYOR

Saneholtz & Associates, LLC

P.O. Box 2628 Whitehouse, OH 43571
Phone: (419) 877-0400
Fax: (419) 877-1140
Mobile: (419) 350-8818
E-Mail: ss@saneholtz.com

P.O. Box 964 Bryan, OH 43506
Phone: (419) 636-5828
Fax: (419) 636-5838
Mobile: (419) 438-2566
E-Mail: pj@saneholtz.com

REV.	DESCRIPTION	BY	DATE

JOB NAME: START HIGH SCHOOL	JOB NUMBER: 051S00956	DRAWN BY: RMG
	SCALE: 1" = 30'	SURVEY BY: DP
	DATE: 11/15/05	CHECKED BY: TAG
CLIENT NAME: APC	OUPS TICKET NUMBER: ----	SHEET
DESCRIPTION: ASBUILT SURVEY DRAWING	DRAWING NAME: 051-00956ASBUILT-1.DWG	1 of 1